


TOWER 56

PLAZA DISTRICT
126 EAST 56TH STREET

11TH FL AS-BUILT | 5,648 RSF

- 2 Offices
- 20 Workstations
- 1 Pantry
- 2 Conference Rooms

East 56 Street

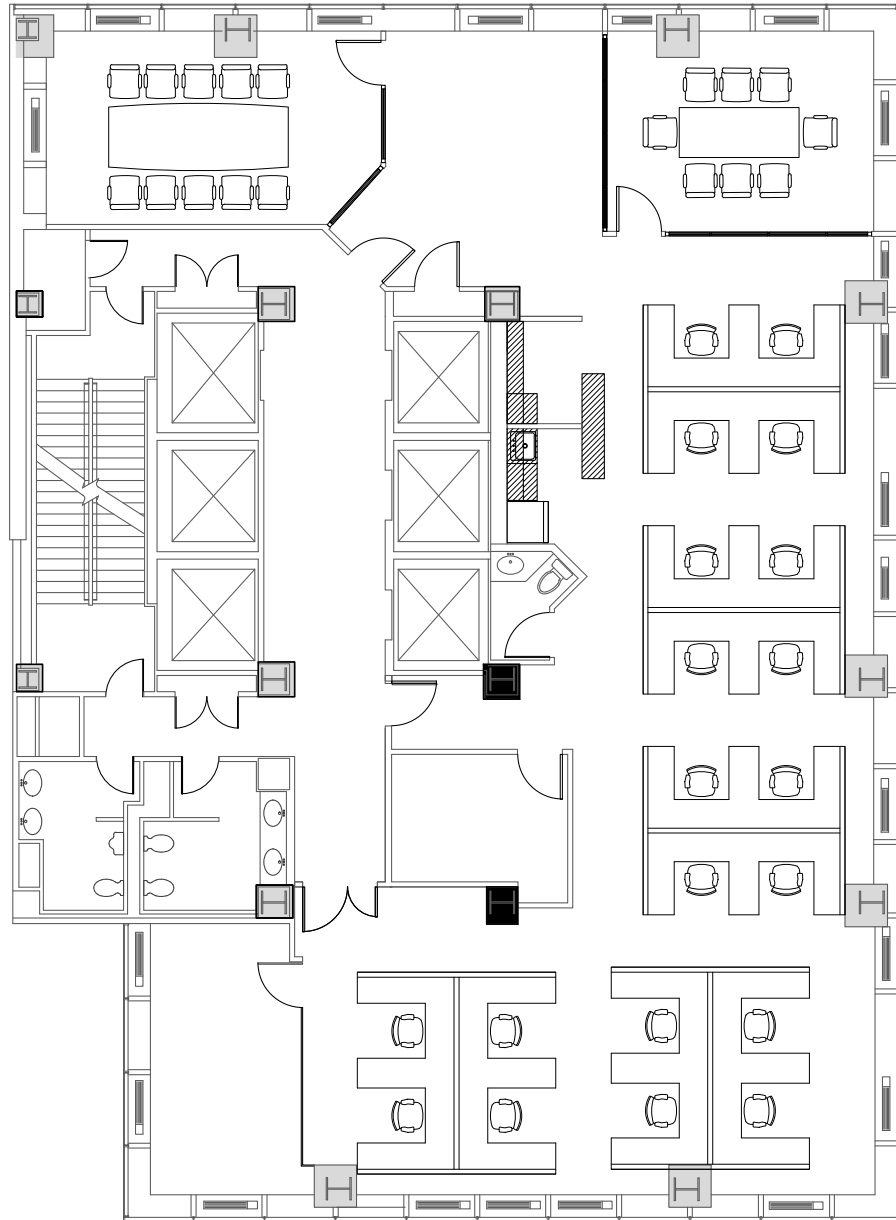

East 55 Street

Sean N. Kearns | 212.841.7517
sean.kearns@cushwake.com



TOWER56NYC.COM



Harry F. Blair | 212.841.5996
harry.blair@cushwake.com

Owner:
PEARLMARK
REAL ESTATE PARTNERS

A full commission computed and earned in accordance with the rates and conditions of our agency agreement with our principal, when received from our principal, will be paid to the cooperating broker who consummates a lease which is unconditionally executed and delivered by and between lessor and lessee (a copy of the rates and conditions referred to above is available upon request).

