

TOWER 56

PLAZA DISTRICT
126 EAST 56TH STREET

Floor 11
As-Built
5,648 RSF

2 Offices


27 Benches

1 Conference Room

1 Pantry/ Copy

1 IT Closet/ Storage

1 Closet

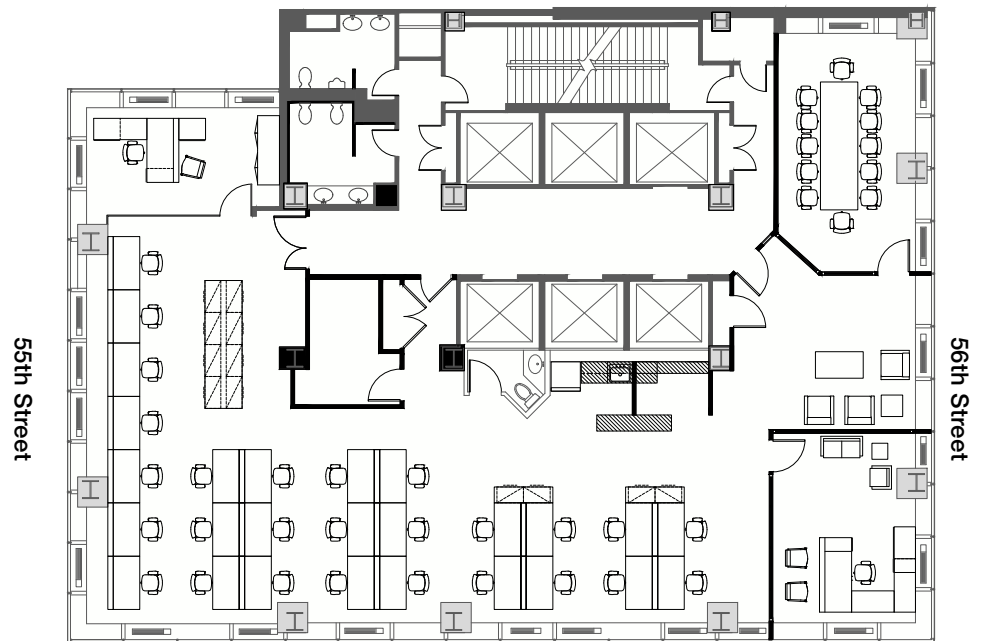


CONTACT:

Sean N. Kearns
212.841.7517
sean.kearns@cushwake.com

Harry F. Blair
212.841.5996
harry.blair@cushwake.com



tower56nyc.com

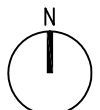

No representation is made to the accuracy of the information furnished herein and same is submitted subject to errors, omission, change of prices, rental, or other conditions, prior sale, lease, and/or withdrawal without notice. The furnishing of this information shall not be deemed a hiring. A commission in accordance with our principal's schedule of rates and conditions will be paid to the procuring Broker executing owner's brokerage agreement who fully consummates a lease upon terms and conditions acceptable to our principal.