

# TOWER 56

PLAZA DISTRICT  
126 EAST 56TH STREET

**Floor 11**  
**As-Built**  
**5,648 RSF**

---

---

2 Offices

---

---

27 Benches

---

---

1 Conference Room

---

---

1 Pantry/ Copy

---


---

1 IT Closet/ Storage

---

---

1 Closet

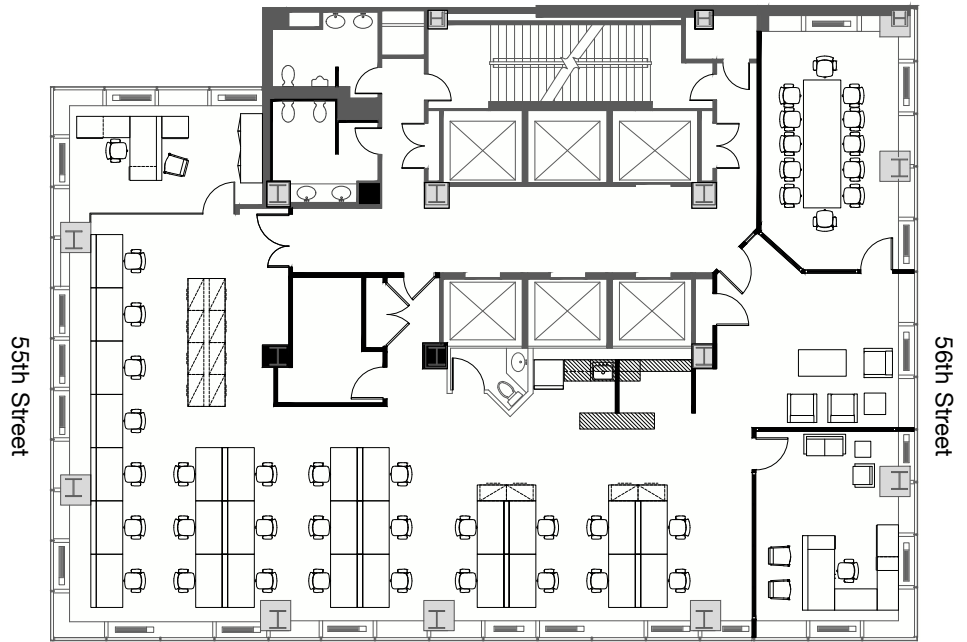


## CONTACT:

Sean N. Kearns  
212.841.7517  
sean.kearns@cushwake.com

Harry F. Blair  
212.841.5996  
harry.blair@cushwake.com



**tower56nyc.com**

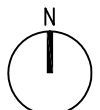

No representation is made to the accuracy of the information furnished herein and same is submitted subject to errors, omission, change of prices, rental, or other conditions, prior sale, lease, and/or withdrawal without notice. The furnishing of this information shall not be deemed a hiring. A commission in accordance with our principal's schedule of rates and conditions will be paid to the procuring Broker executing owner's brokerage agreement who fully consummates a lease upon terms and conditions acceptable to our principal.