


# TOWER 56

PLAZA DISTRICT  
126 EAST 56TH STREET


SUITE 1910 AS-BUILT | 3,609 RSF

- 4 Private Offices
- 11 Workstations
- 1 Conference Room
- 1 Pantry

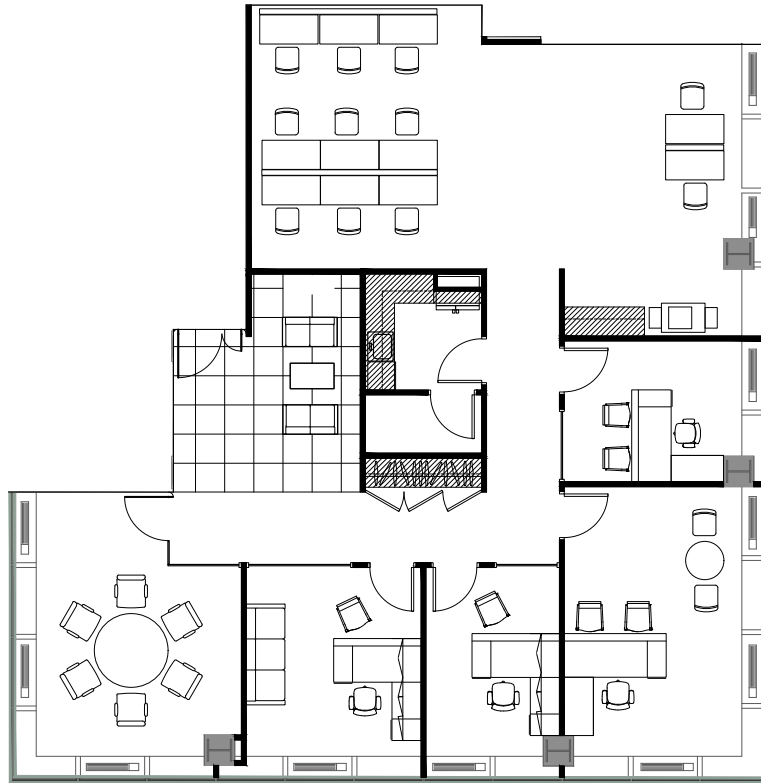

East 55 Street

East 56 Street

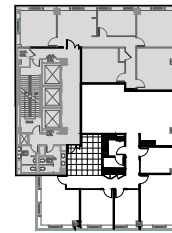

East 55 Street



Sean N. Kearns | 212.841.7517  
sean.kearns@cushwake.com



TOWER56NYC.COM



Harry F. Blair | 212.841.5996  
harry.blair@cushwake.com

Owner:  
**PEARLMARK**  
REAL ESTATE PARTNERS

A full commission computed and earned in accordance with the rates and conditions of our agency agreement with our principal, when received from our principal, will be paid to the cooperating broker who consummates a lease which is unconditionally executed and delivered by and between lessor and lessee (a copy of the rates and conditions referred to above is available upon request).

