

TOWER56

PLAZA DISTRICT | 126 E 56




Suite 910

As-Built Plan
2,582 RSF

Highlights

- Newly furnished
- Move-in ready
- Bright space
- Glass office fronts
- Building renovation underway featuring new lobby and multi-level amenity center

2	Private Offices	1	Conference Room
12	Open Area	1	Pantry
14	Total Headcount	1	I.T.

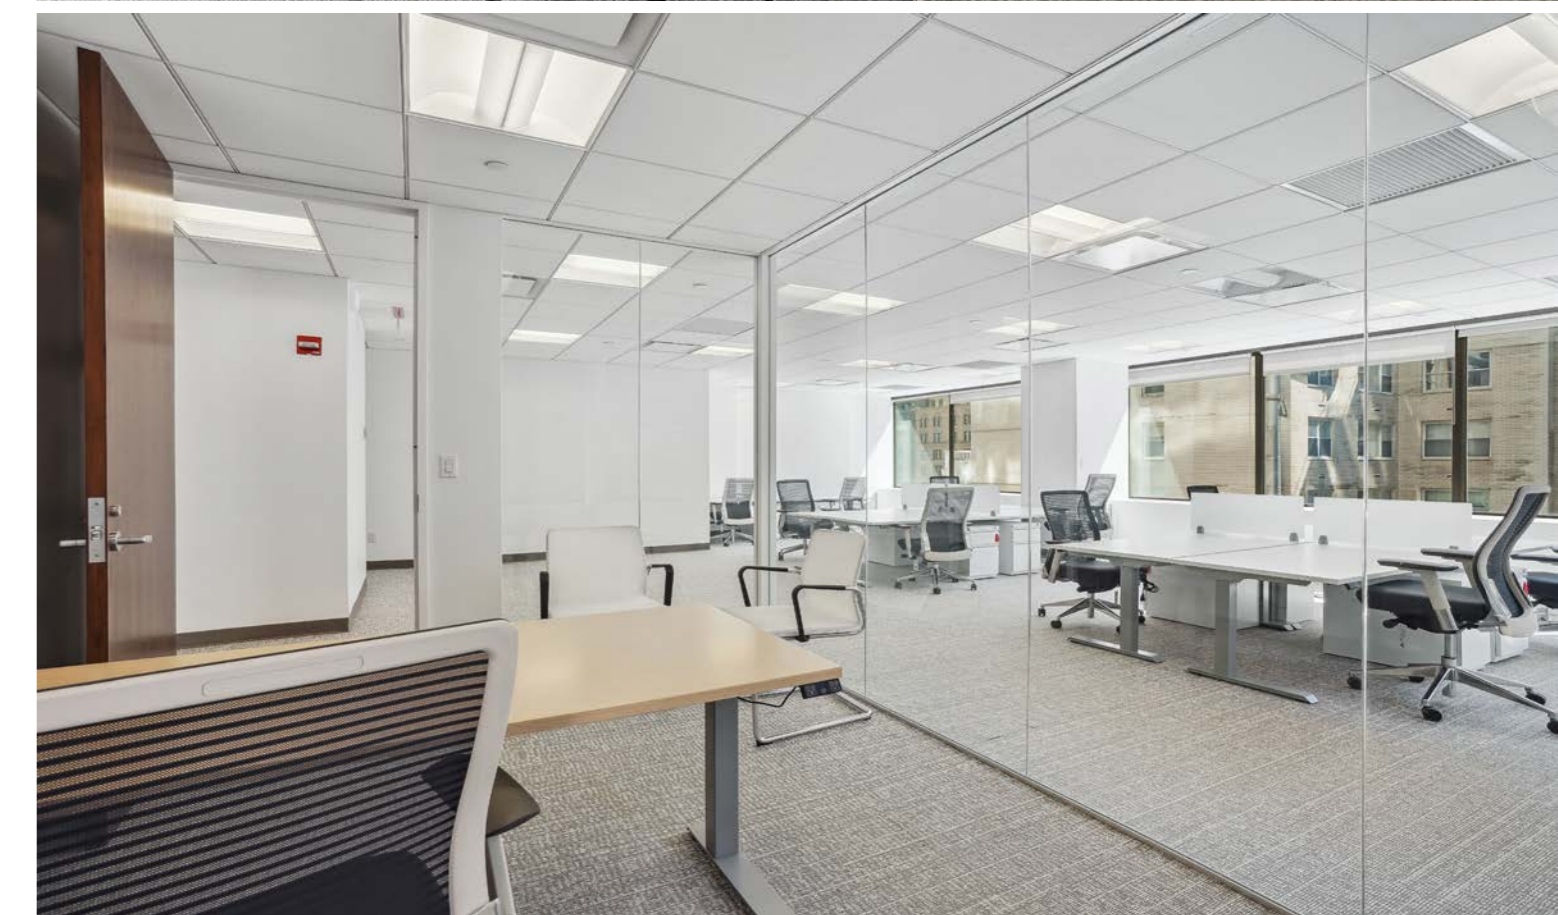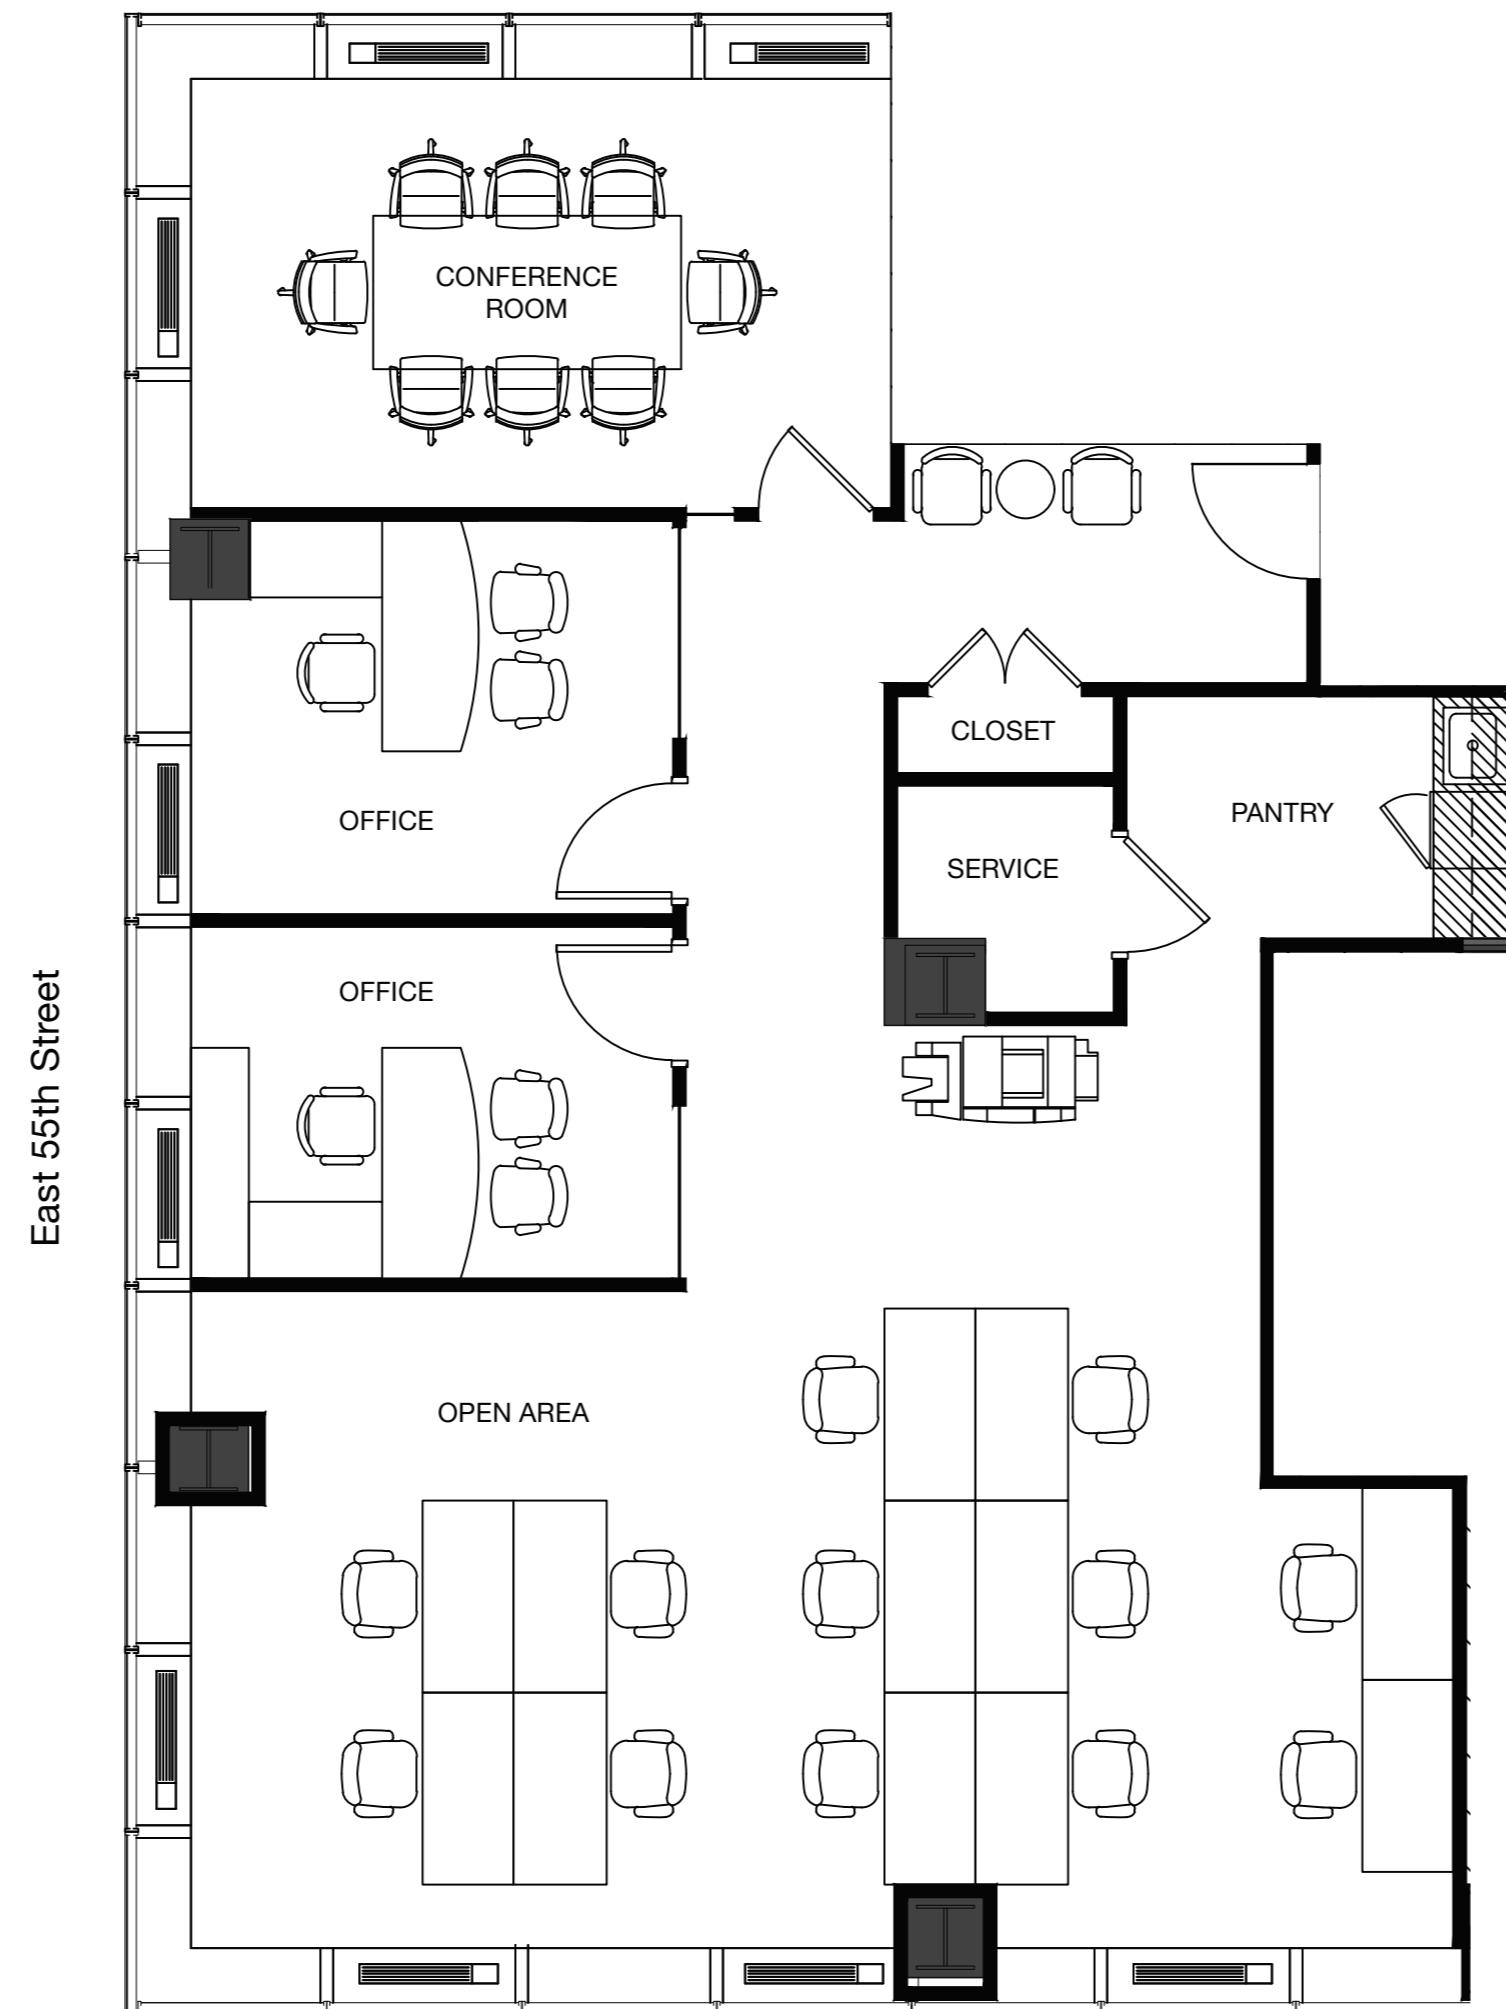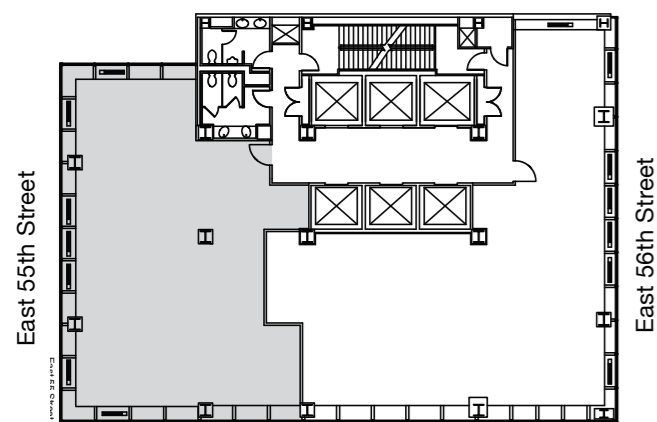

Sean Kearns | 212.984.6635 | sean.kearns@cbre.com

Alice Fair | 212.895.0985 | alice.fair@cbre.com

Graham Walter | 212.984.8059 | graham.walter@cbre.com



© 2023 CBRE, Inc. All rights reserved. This information has been obtained from sources believed reliable, but has not been verified for accuracy or completeness. You should conduct a careful, independent investigation of the property and verify all information. Any reliance on this information is solely at your own risk. CBRE and the CBRE logo are service marks of CBRE, Inc. All other marks displayed on this document are the property of their respective owners, and the use of such logos does not imply any affiliation with or endorsement of CBRE.

