

# TOWER56

PLAZA DISTRICT | 126 E 56



## Suite 1020

As-Built Plan  
3,774 RSF

### Highlights

- Excellent light
- Move-in ready
- Glass office fronts
- Furnishing options available
- Building renovation underway featuring new lobby and multi-level amenity center

7	Offices	1	Conference Room
4	Open Area	1	Pantry
1	Reception	1	I.T.
<b>13</b>	<b>Total Headcount</b>		

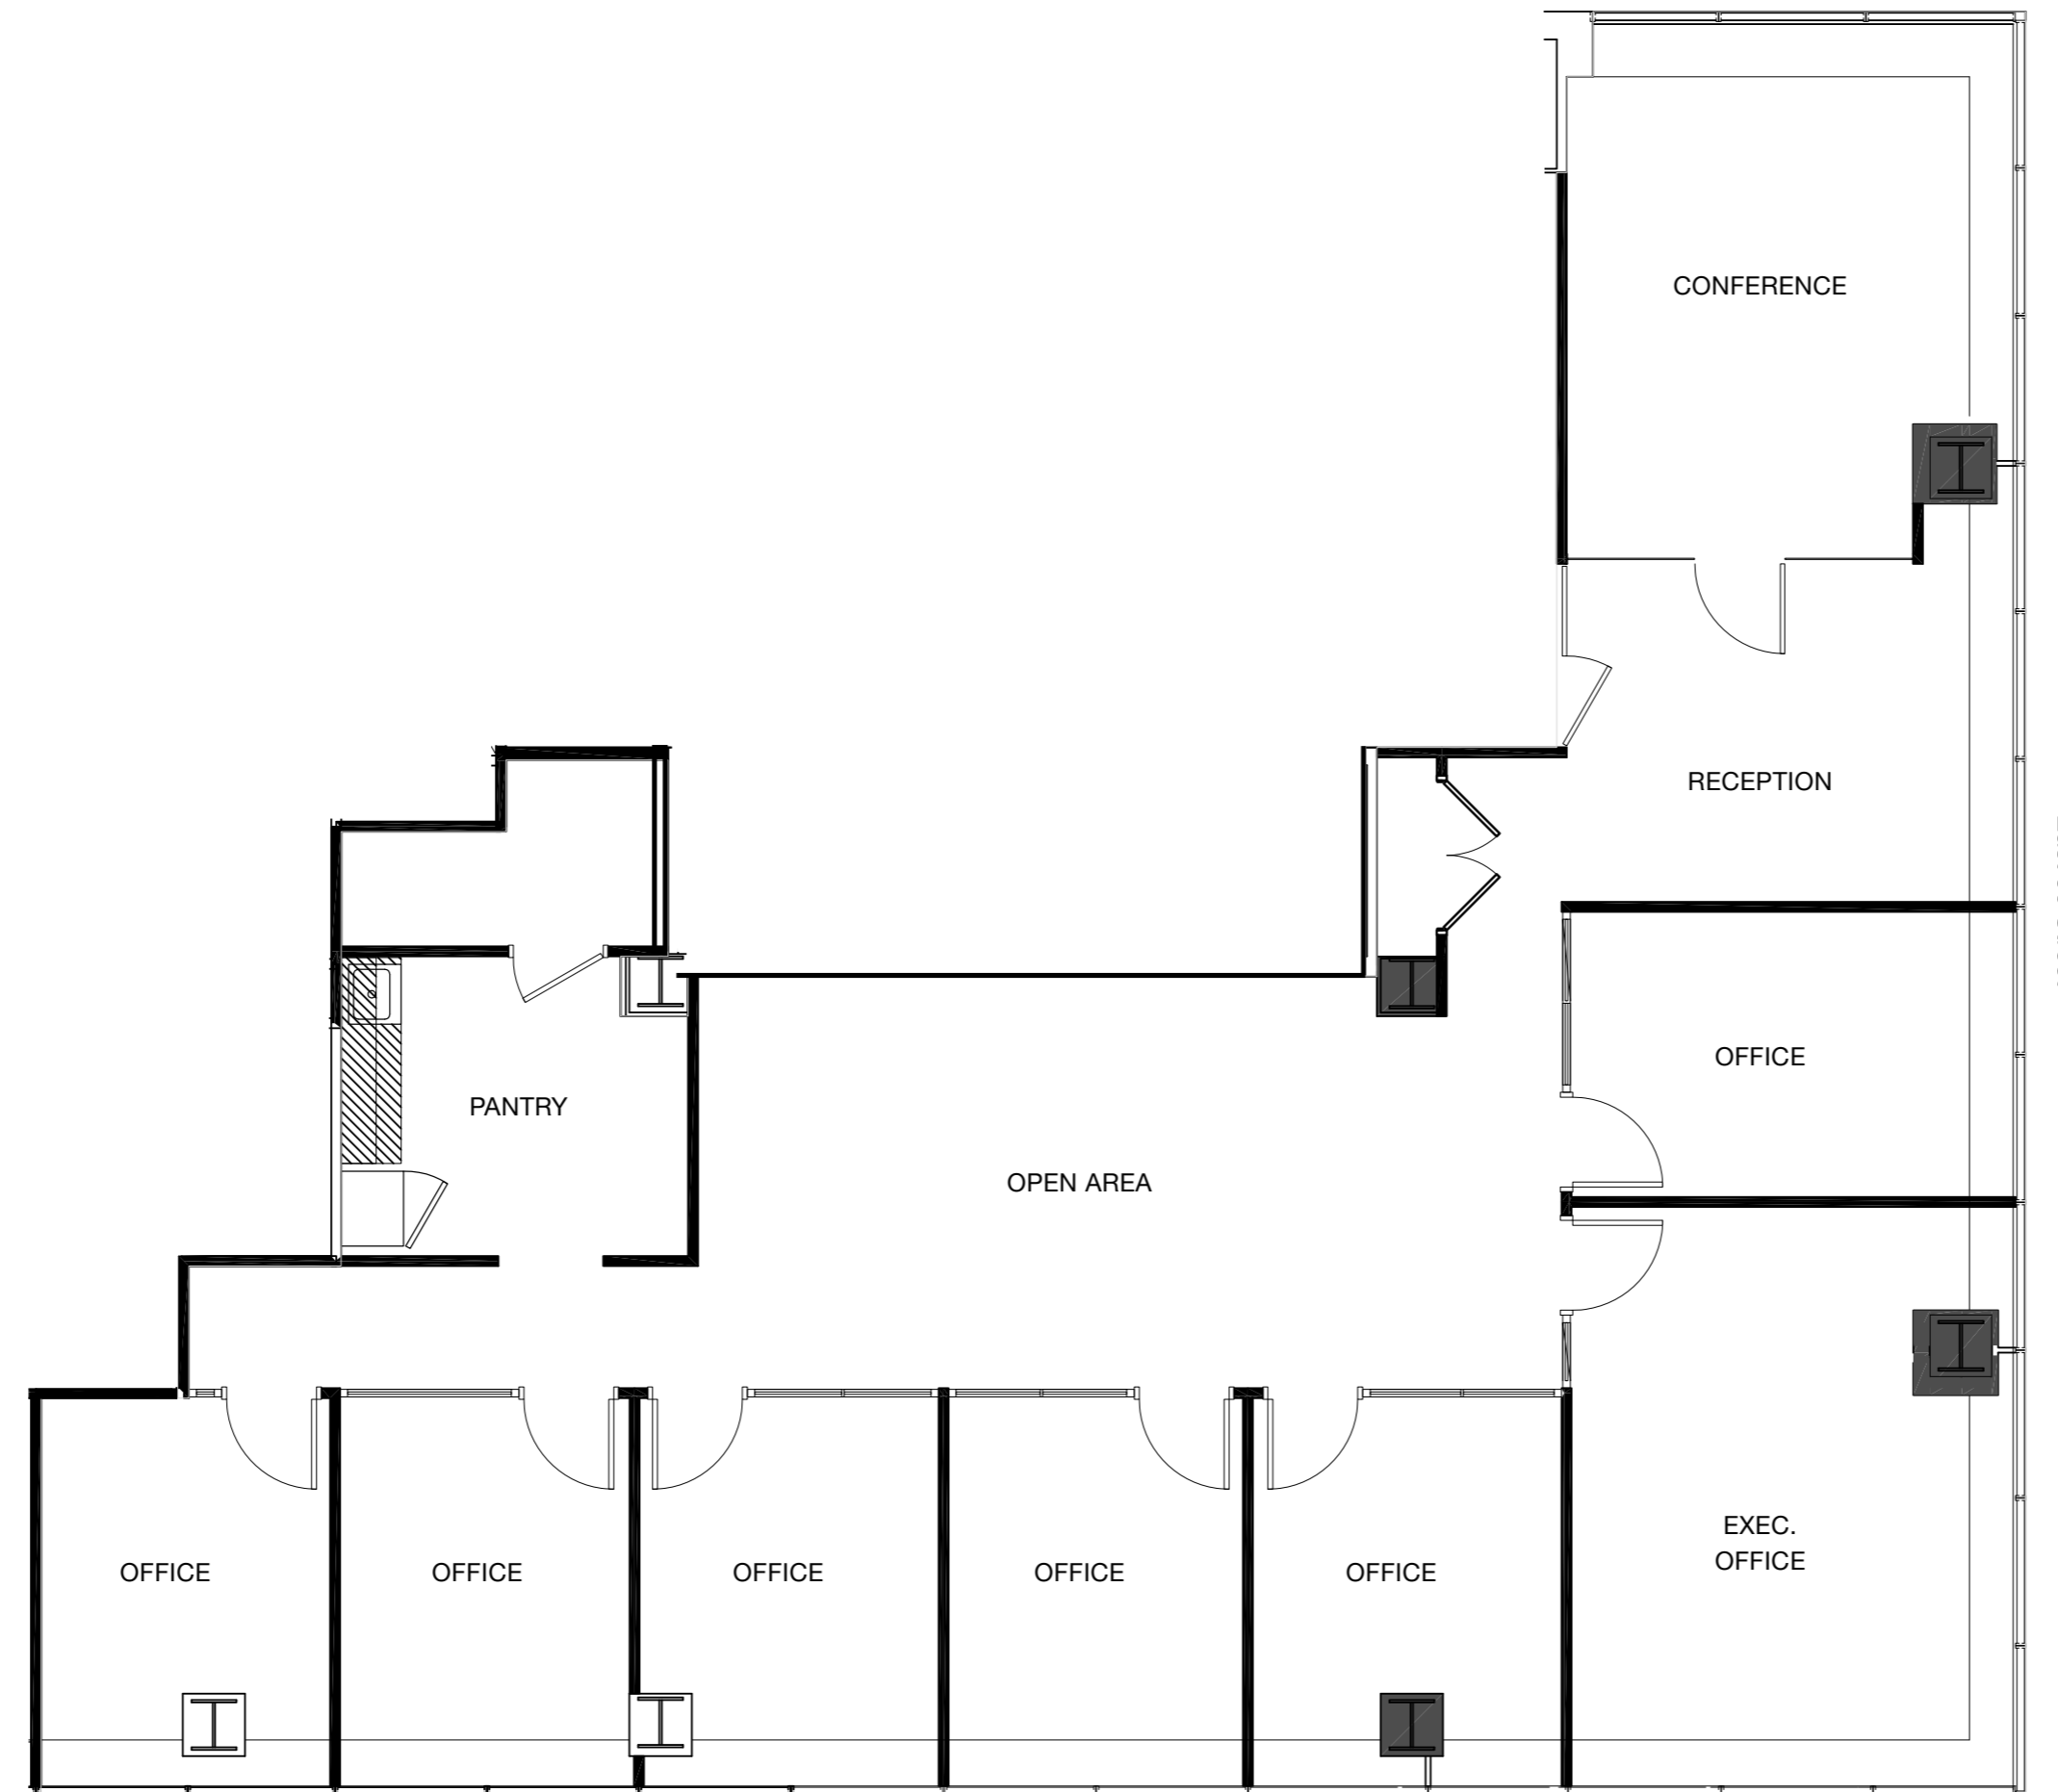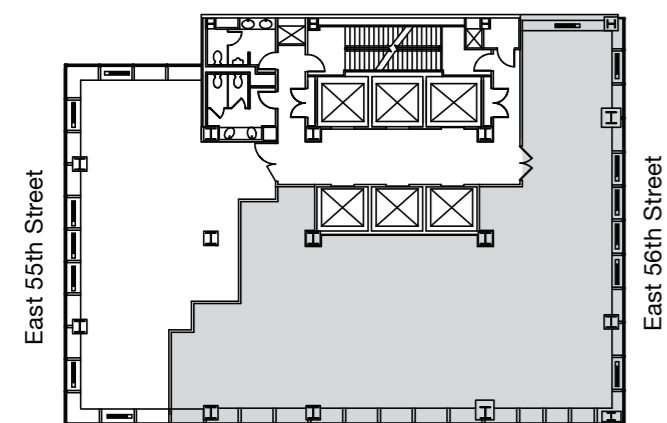

Sean Kearns | 212.984.6635 | sean.kearns@cbre.com

Alice Fair | 212.895.0985 | alice.fair@cbre.com

Graham Walter | 212.984.8059 | graham.walter@cbre.com



© 2023 CBRE, Inc. All rights reserved. This information has been obtained from sources believed reliable, but has not been verified for accuracy or completeness. You should conduct a careful, independent investigation of the property and verify all information. Any reliance on this information is solely at your own risk. CBRE and the CBRE logo are service marks of CBRE, Inc. All other marks displayed on this document are the property of their respective owners, and the use of such logos does not imply any affiliation with or endorsement of CBRE.

