


# TOWER 56

PLAZA DISTRICT | 126 E 56

## Entire 14th Floor

As-Built

5,648 RSF

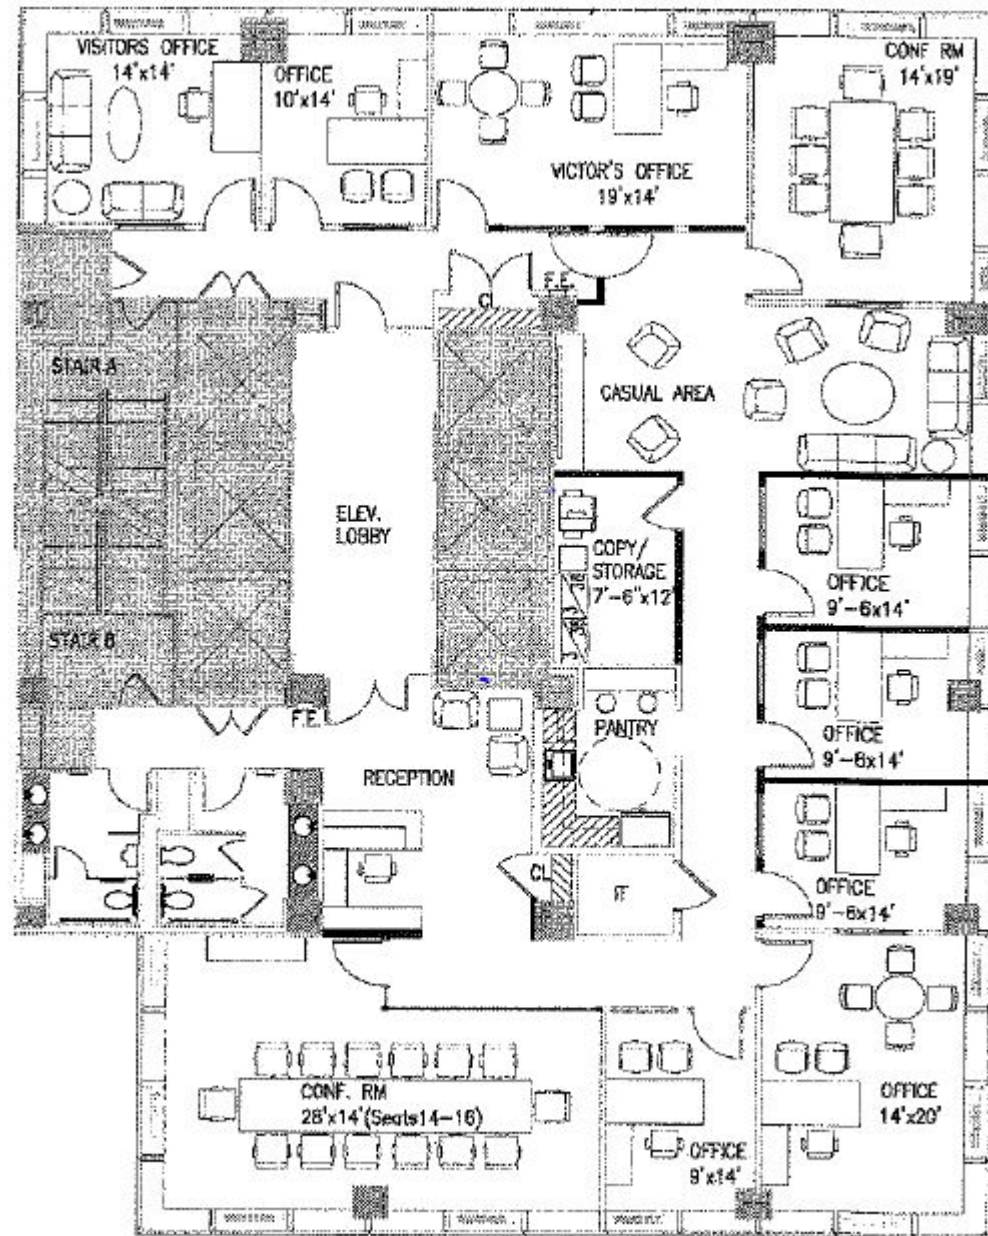

[tower56nyc.com](http://tower56nyc.com)

No warranty or representation, express or implied, is made as to the condition of the property (or properties) referenced herein or as to the accuracy or completeness of the information contained herein, and same is submitted subject to errors, omissions, change of price, rental or other conditions, withdrawal without notice, and to any special listing conditions imposed by the property owner(s). Any projections, opinions or estimates are subject to uncertainty and do not signify current or future property performance.

